

**080481** GAS POUCH 406 X 572 X 165 MM

**080481** GAS POUCH 406 X 572 X 165 MM


AOUBO - Lotto 18 - Kit Ossig peso da 20 a 40 Kg

080456  
PEELABLE TRAY LID


WHITE COTTON RIBBON  
60 cm

080455  
SASH TRAY



LEFT  
080777  
FOAM INSERT

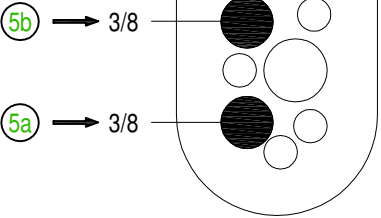


RIGHT  
080462  
FOAM INSERT

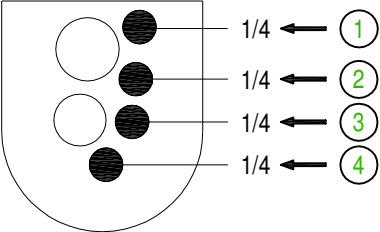


6.

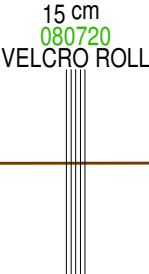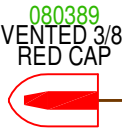

080025  
SILICONE  
1/4 x 1/16  
150 cm

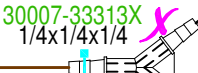


3061070  
PVC 70 SH  
1/4 x 1/16  
40 cm

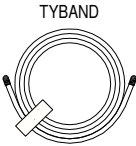


1a 6a.


7.

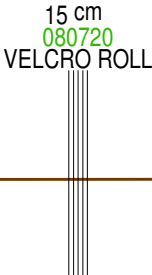

080025  
SILICONE  
1/4 x 1/16  
110 cm

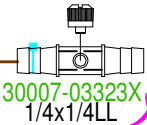

2b 7a.

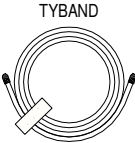

8.







3061070  
PVC 70 SH  
1/4 x 1/16  
100 cm



PACCO 4




LABEL

080417 BLUE TOWEL ONLY USE 1/2 OF THE TOWEL

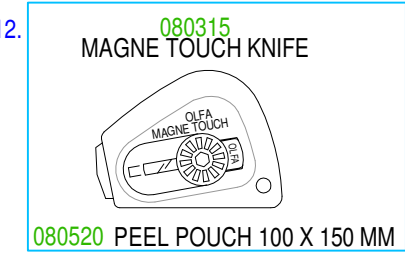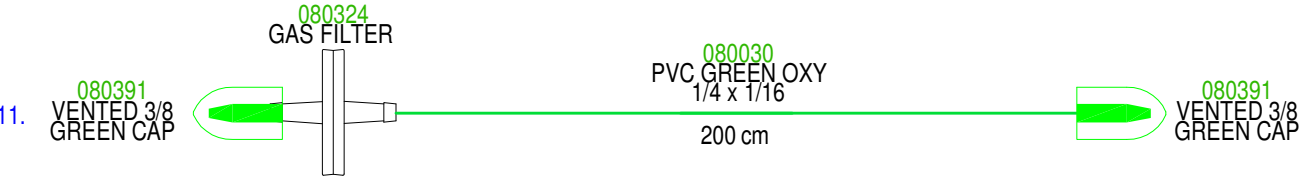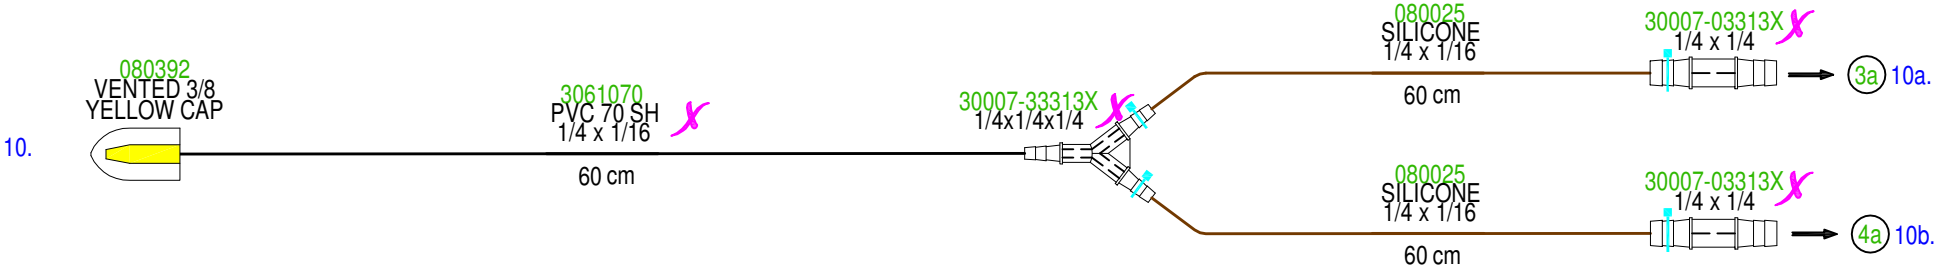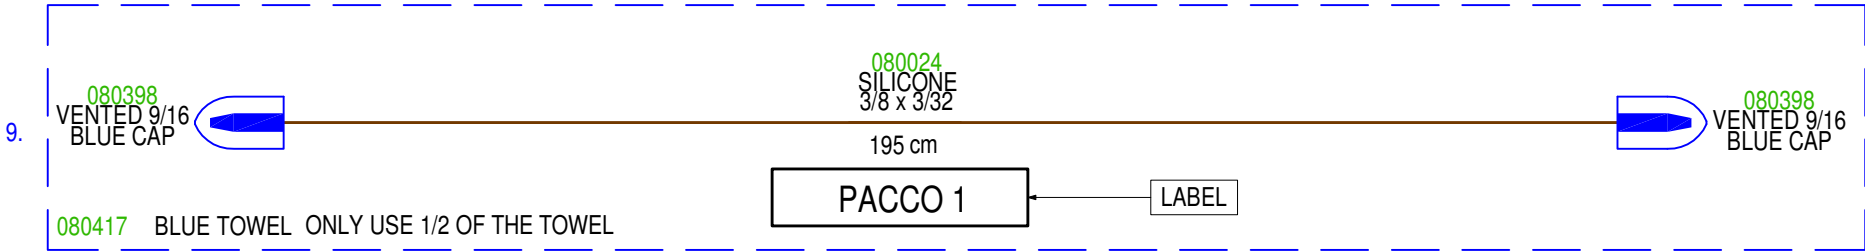

AOUBO - Lotto 18 - Kit Ossig peso da 20 a 40 Kg

CP LAYER PAD  
080856  
0.25

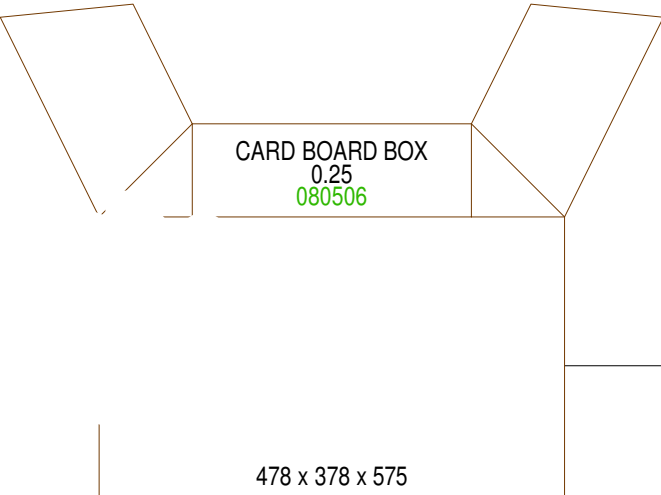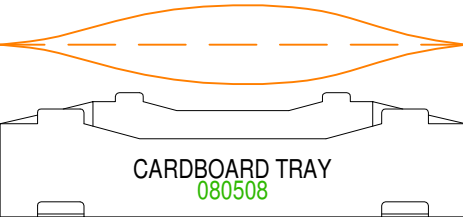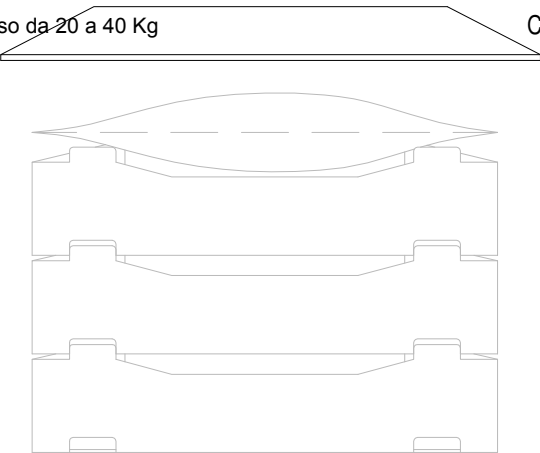


PACKING INFORMATION

EACH GAS POUCH IS TO BE PACKED IN A CARDBOARD TRAY, ONE ON TOP OF ANOTHER. 4 PACKS PER BOX

PACKING ORDER TO BE CONFIRMED ON FIRST PRODUCTION AND IMAGES TAKEN.



PACK LABEL EXAMPLE

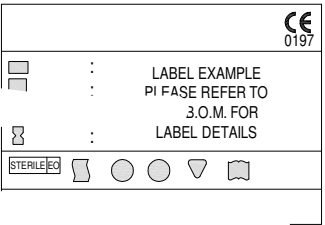

BOX LABEL EXAMPLE

